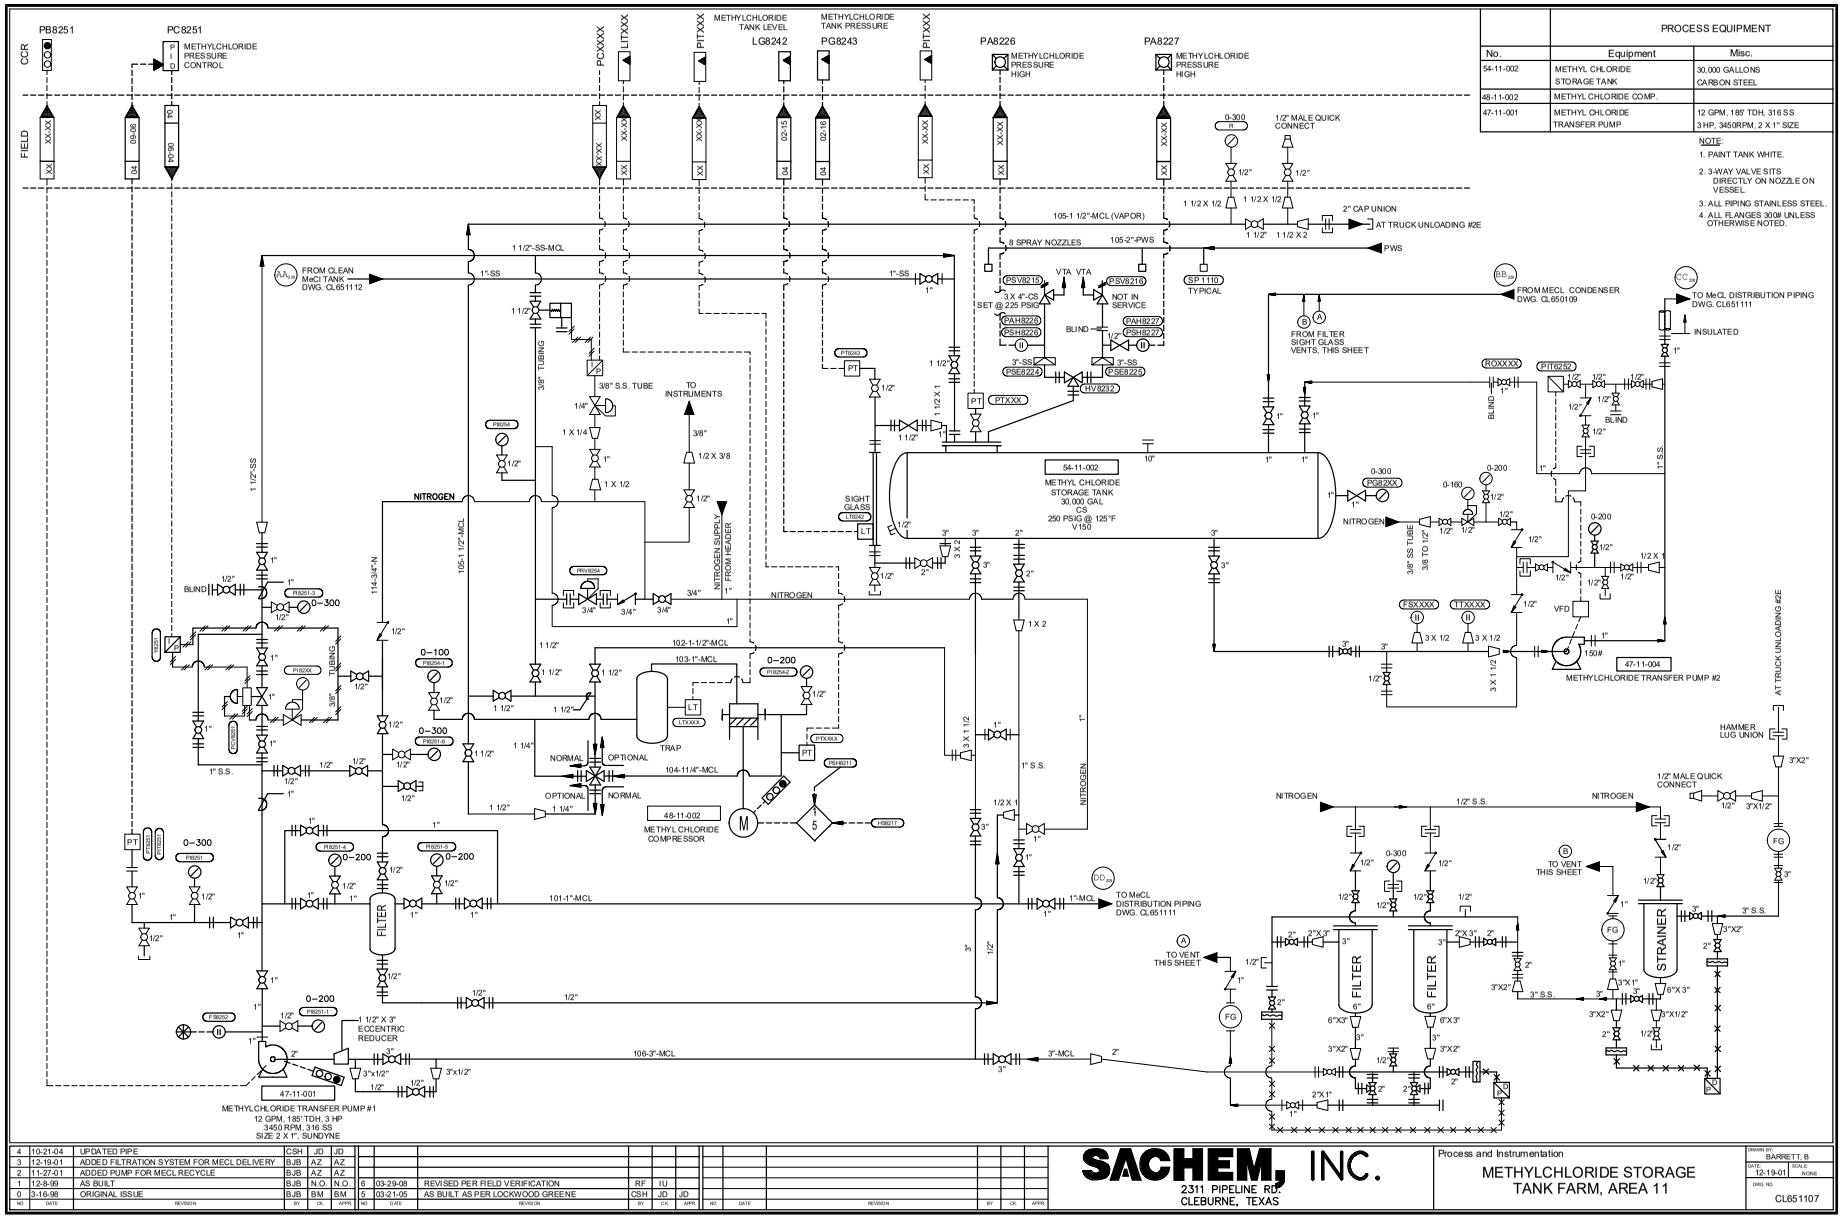
PROCESS EQUIPMENT
No. | Equipment | Misc.
54-11-002 | METHYL CHLORIDE STORAGE TANK | 30,000 GALLONS CARBON STEEL
48-11-002 | METHYL CHLORIDE COMP.
47-11-001 | METHYL CHLORIDE TRANSFER PUMP | 12 GPM, 185' TDH, 316 SS 3 HP, 3450RPM, 2 X 1" SIZE
NOTE:
1. PAINT TANK WHITE.
2. 3-WAY VALVE SITS DIRECTLY ON NOZZLE ON VESSEL.
3. ALL PIPING STAINLESS STEEL.
4. ALL FLANGES 300# UNLESS OTHERWISE NOTED.
CCR
FIELD
PB8251
PC8251
METHYLCHLORIDE PRESSURE CONTROL
PCXXXX
LITXXX
PITXXX
METHYLCHLORIDE TANK LEVEL
LG8242
METHYLCHLORIDE TANK PRESSURE
PG8243
PITXXX
PA8226
METHYLCHLORIDE PRESSURE HIGH
PA8227
METHYLCHLORIDE PRESSURE HIGH
1/2" MALE QUICK CONNECT
105-1 1/2"-MCL (VAPOR)
2" CAP UNION
AT TRUCK UNLOADING #2E
PWS
105-2"-PWS
8 SPRAY NOZZLES
1 1/2"-SS-MCL
FROM CLEAN MeCl TANK DWG. CL651112
1"-SS
3 X 4"-CS
SET @ 225 PSIG
NOT IN SERVICE
BLIND
FROM FILTER SIGHT GLASS VENTS, THIS SHEET
FROM MeCL CONDENSER DWG. CL650109
TO MeCL DISTRIBUTION PIPING DWG. CL651111
INSULATED
3/8" TUBING
3/8" S.S. TUBE
TO INSTRUMENTS
NITROGEN
NITROGEN SUPPLY FROM HEADER
54-11-002
METHYL CHLORIDE STORAGE TANK 30,000 GAL CS 250 PSIG @ 125°F V150
SIGHT GLASS
3/8" SS TUBE
3/8 TO 1/2"
VFD
150#
47-11-004
METHYLCHLORIDE TRANSFER PUMP #2
AT TRUCK UNLOADING #2E
HAMMER LUG UNION
1/2" MALE QUICK CONNECT
1" S.S.
1/2" S.S.
3" S.S.
114-3/4"-N
105-1 1/2"-MCL
102-1-1/2"-MCL
103-1"-MCL
TRAP
NORMAL
OPTIONAL
104-11/4"-MCL
48-11-002
METHYL CHLORIDE COMPRESSOR
101-1"-MCL
1"-MCL
TO MeCL DISTRIBUTION PIPING DWG. CL651111
TO VENT THIS SHEET
FILTER
6" FILTER
STRAINER
1 1/2" X 3" ECCENTRIC REDUCER
106-3"-MCL
3"-MCL
47-11-001
METHYLCHLORIDE TRANSFER PUMP #1
12 GPM, 185' TDH, 3 HP
3450 RPM, 316 SS
SIZE 2 X 1", SUNDYNE
Date of Plot:
Time of Plot:
Path of File:
Name of File:
4 10-21-04 UPDATED PIPE CSH JD JD
3 12-19-01 ADDED FILTRATION SYSTEM FOR MECL DELIVERY BJB AZ AZ
2 11-27-01 ADDED PUMP FOR MECL RECYCLE BJB AZ AZ
1 12-8-99 AS BUILT BJB N.O. N.O.
0 3-16-98 ORIGINAL ISSUE BJB BM BM
6 03-29-08 REVISED PER FIELD VERIFICATION RF IU
5 03-21-05 AS BUILT AS PER LOCKWOOD GREENE CSH JD JD
SACHEM, INC.
2311 PIPELINE RD.
CLEBURNE, TEXAS
Process and Instrumentation
METHYLCHLORIDE STORAGE TANK FARM, AREA 11
DRAWN BY: BARRETT, B
DATE: 12-19-01
SCALE: NONE
DWG. NO. CL651107